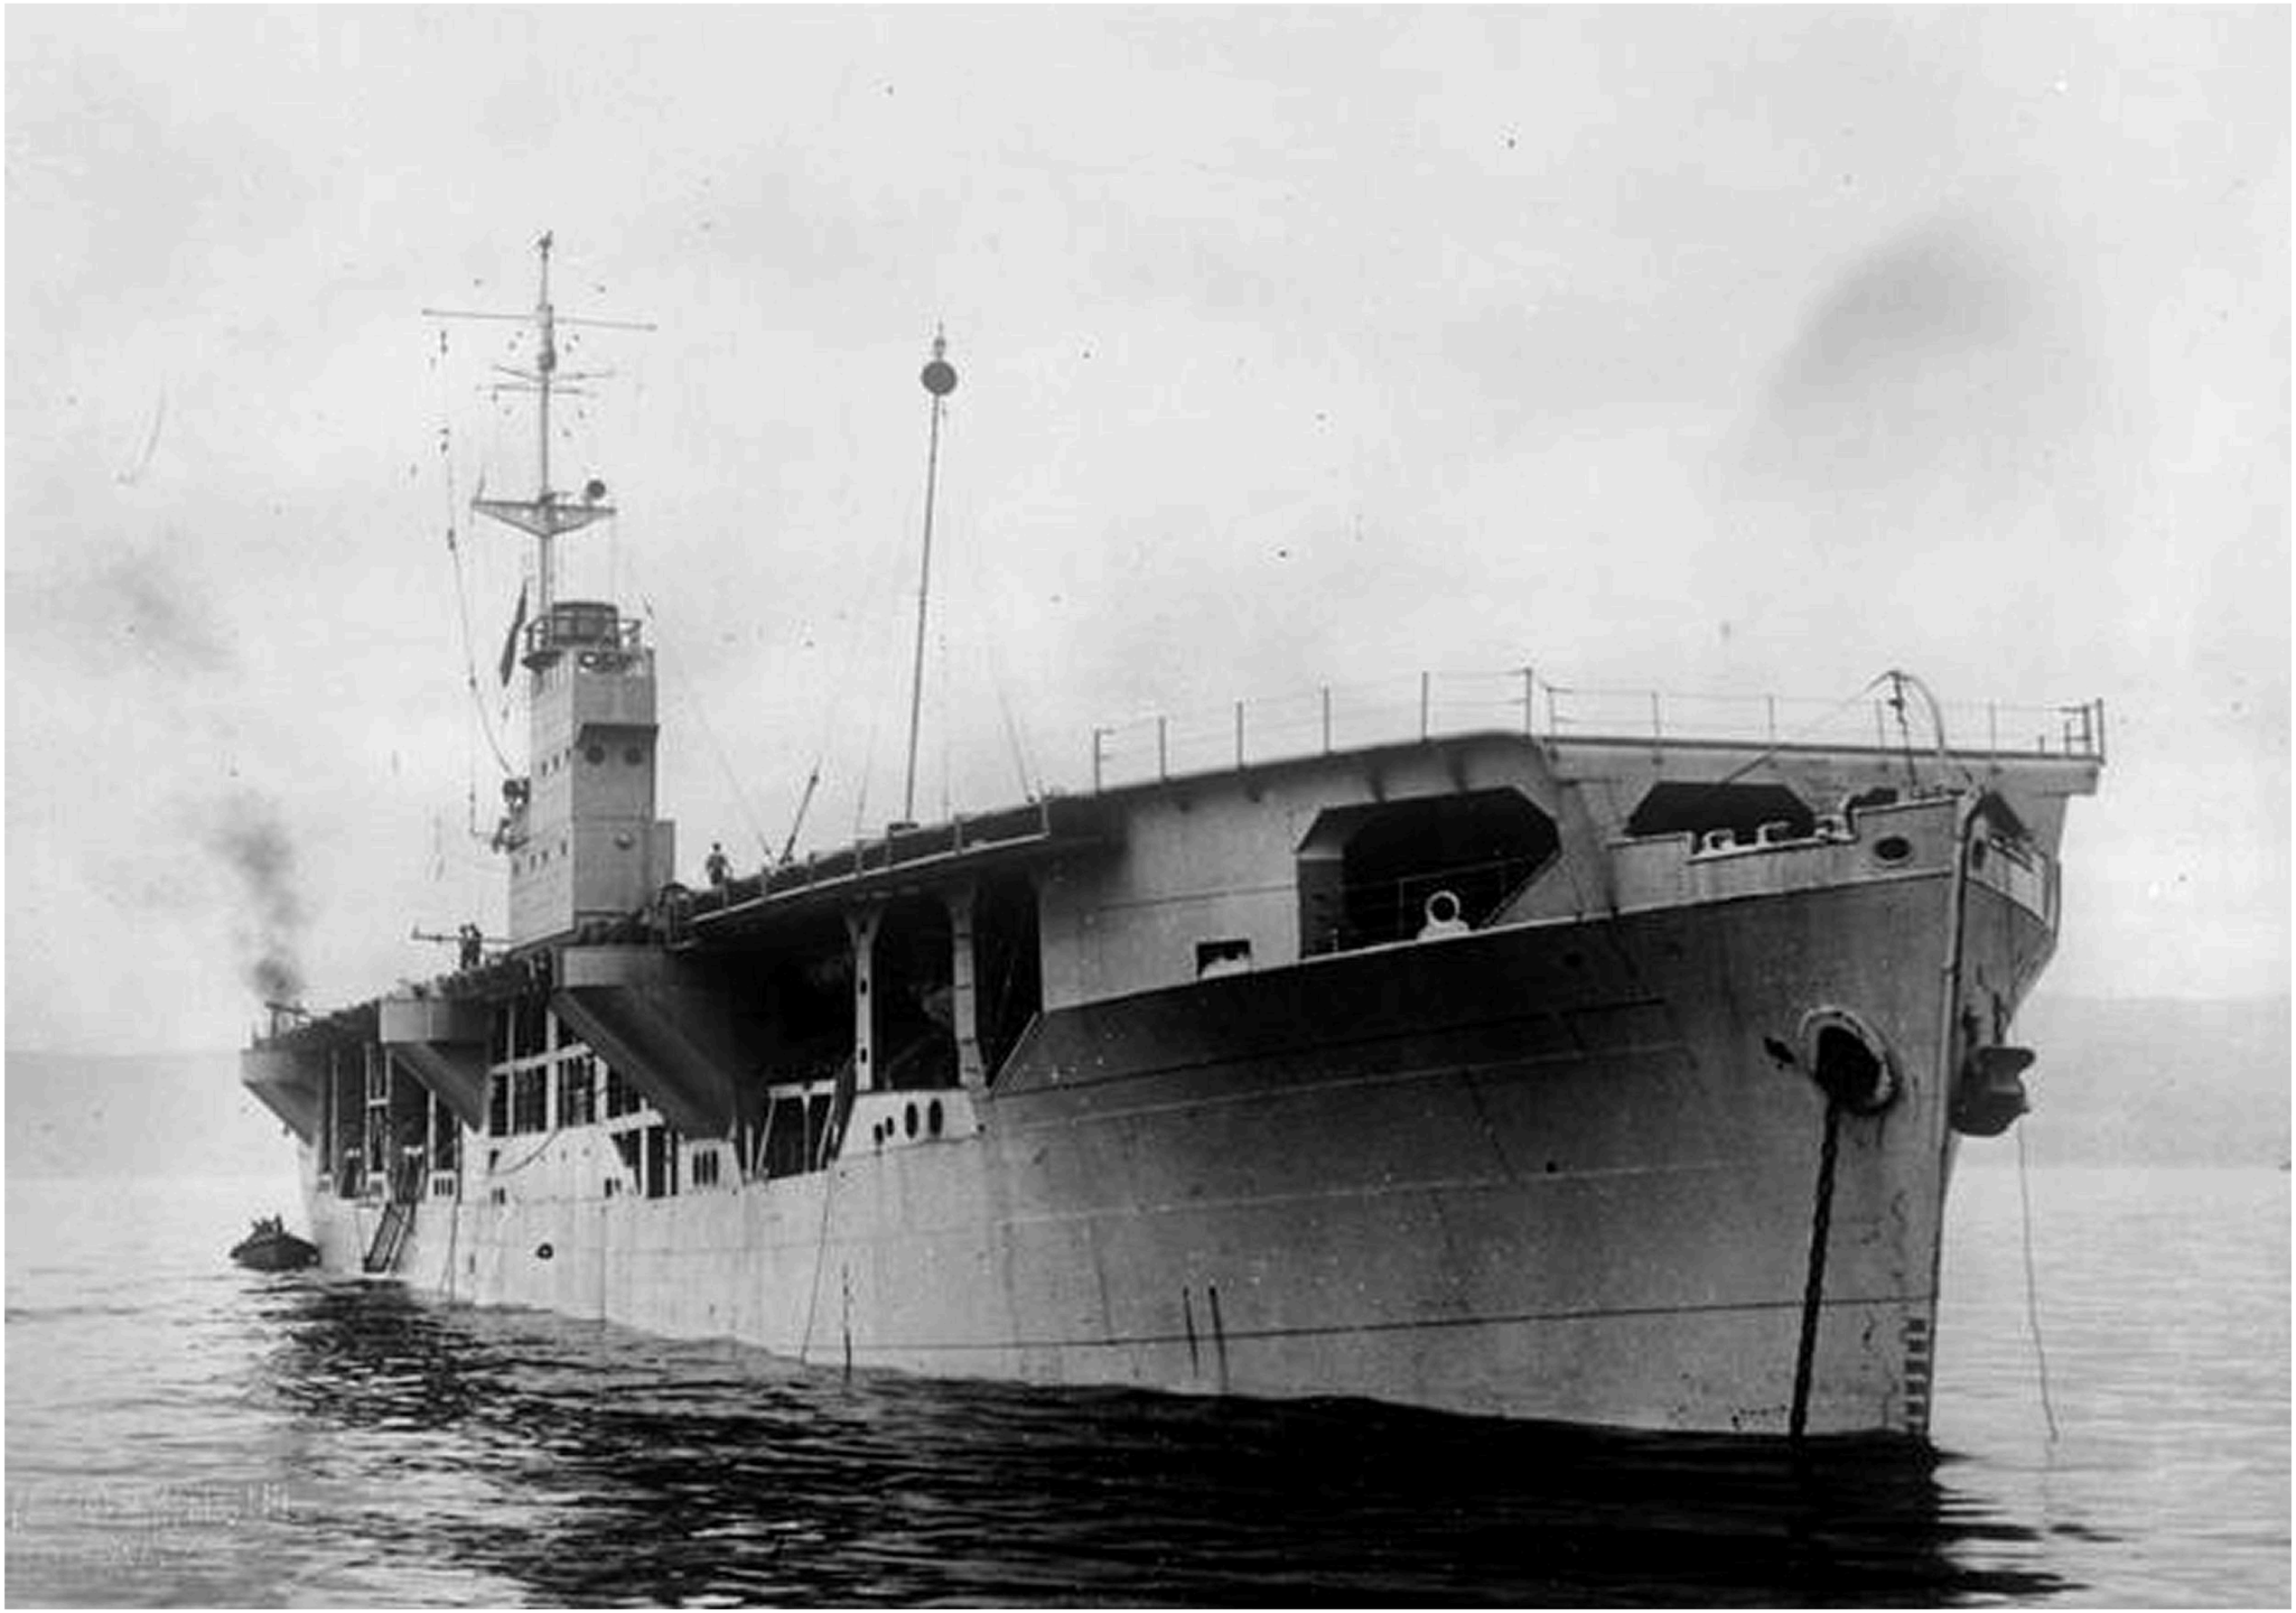

MR YOUNG

003824-003831-0187

© 2020
Lloyd's Register
Foundation

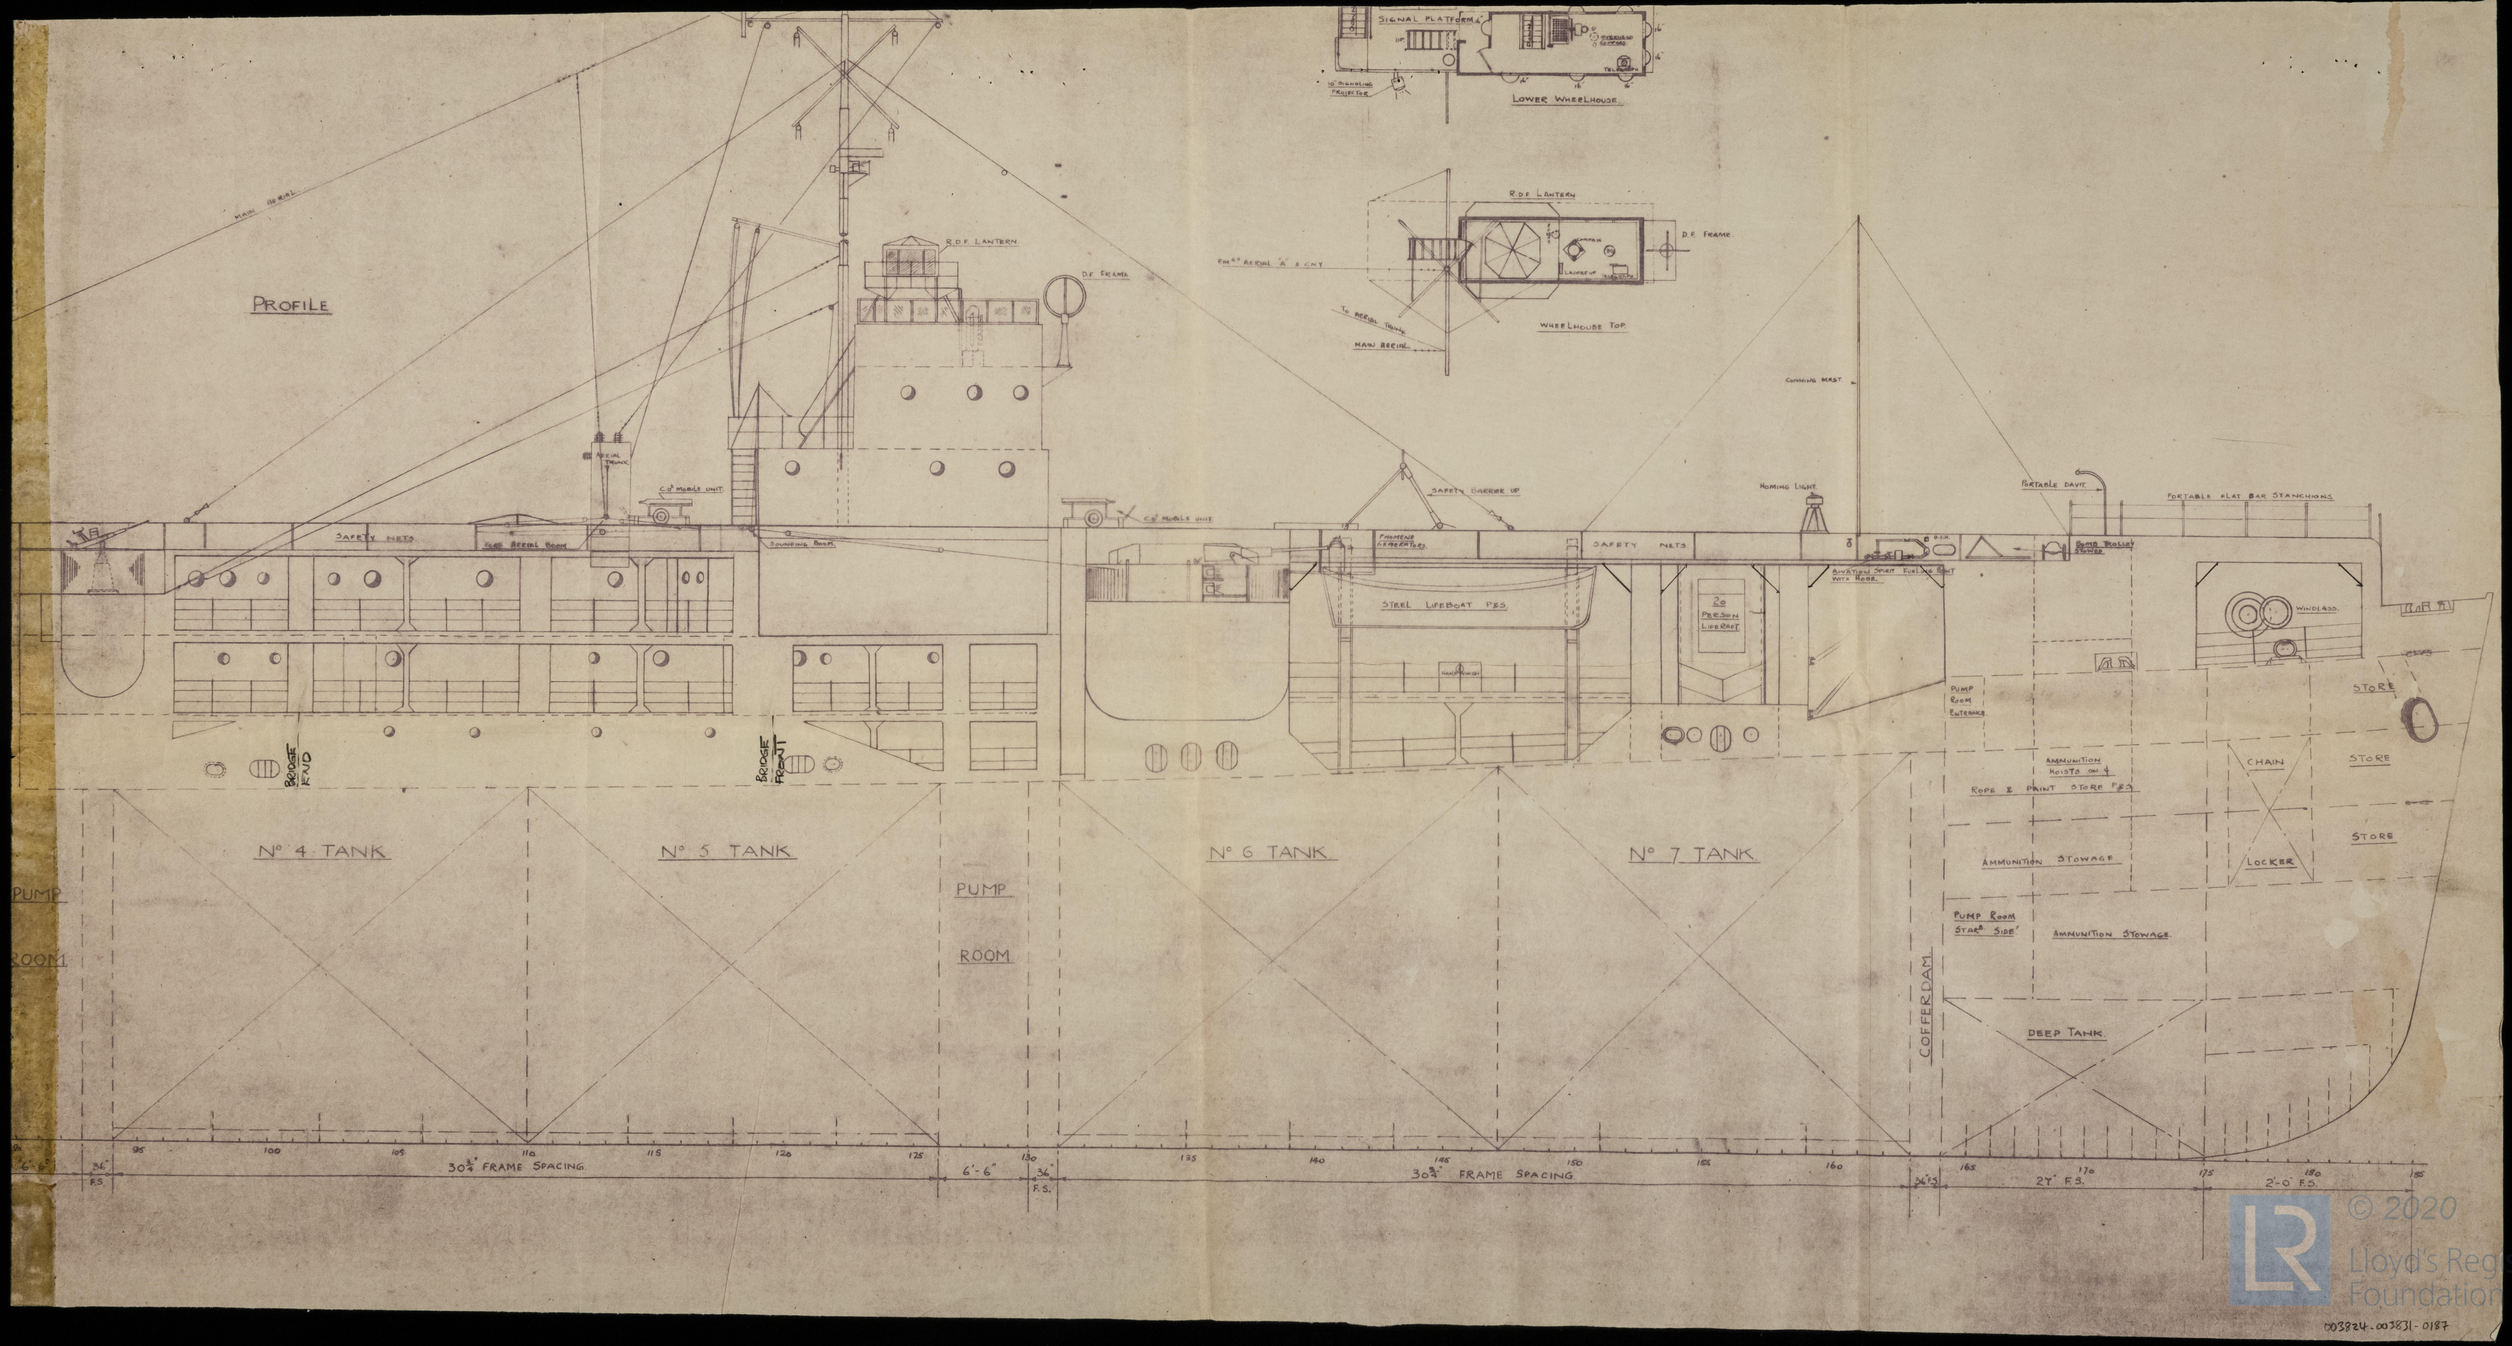

© 2020 Lloyd's Register Foundation

003824-003831-0187

MK YOUNG

© 2020
Lloyd's Register
Foundation

003824.003831-0188

S/W

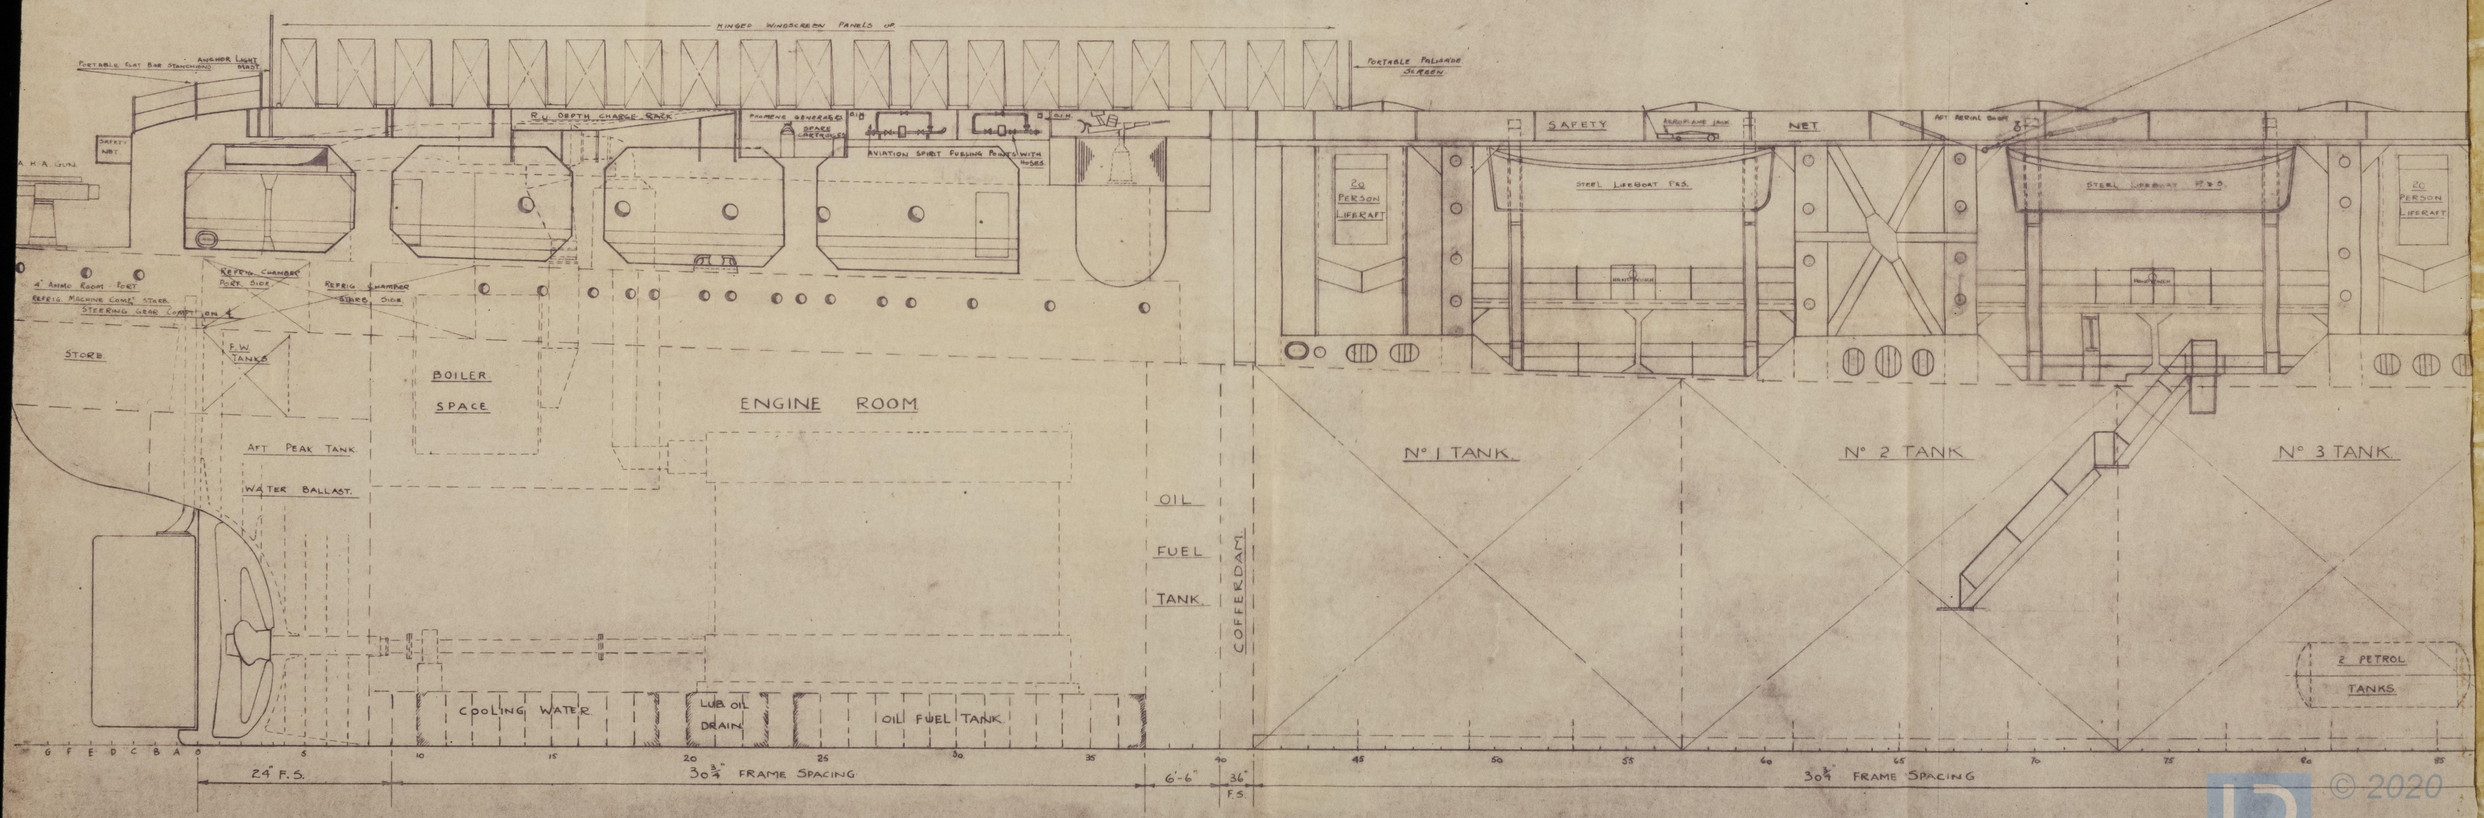

© 2020 Lloyd's Register Foundation

003824-003831-0188

MOTOR TANKER

"RAPANA"

CAST STEEL STERNFR

© 2020
Lloyd's Register Foundation

003824 - 003831 - 0204

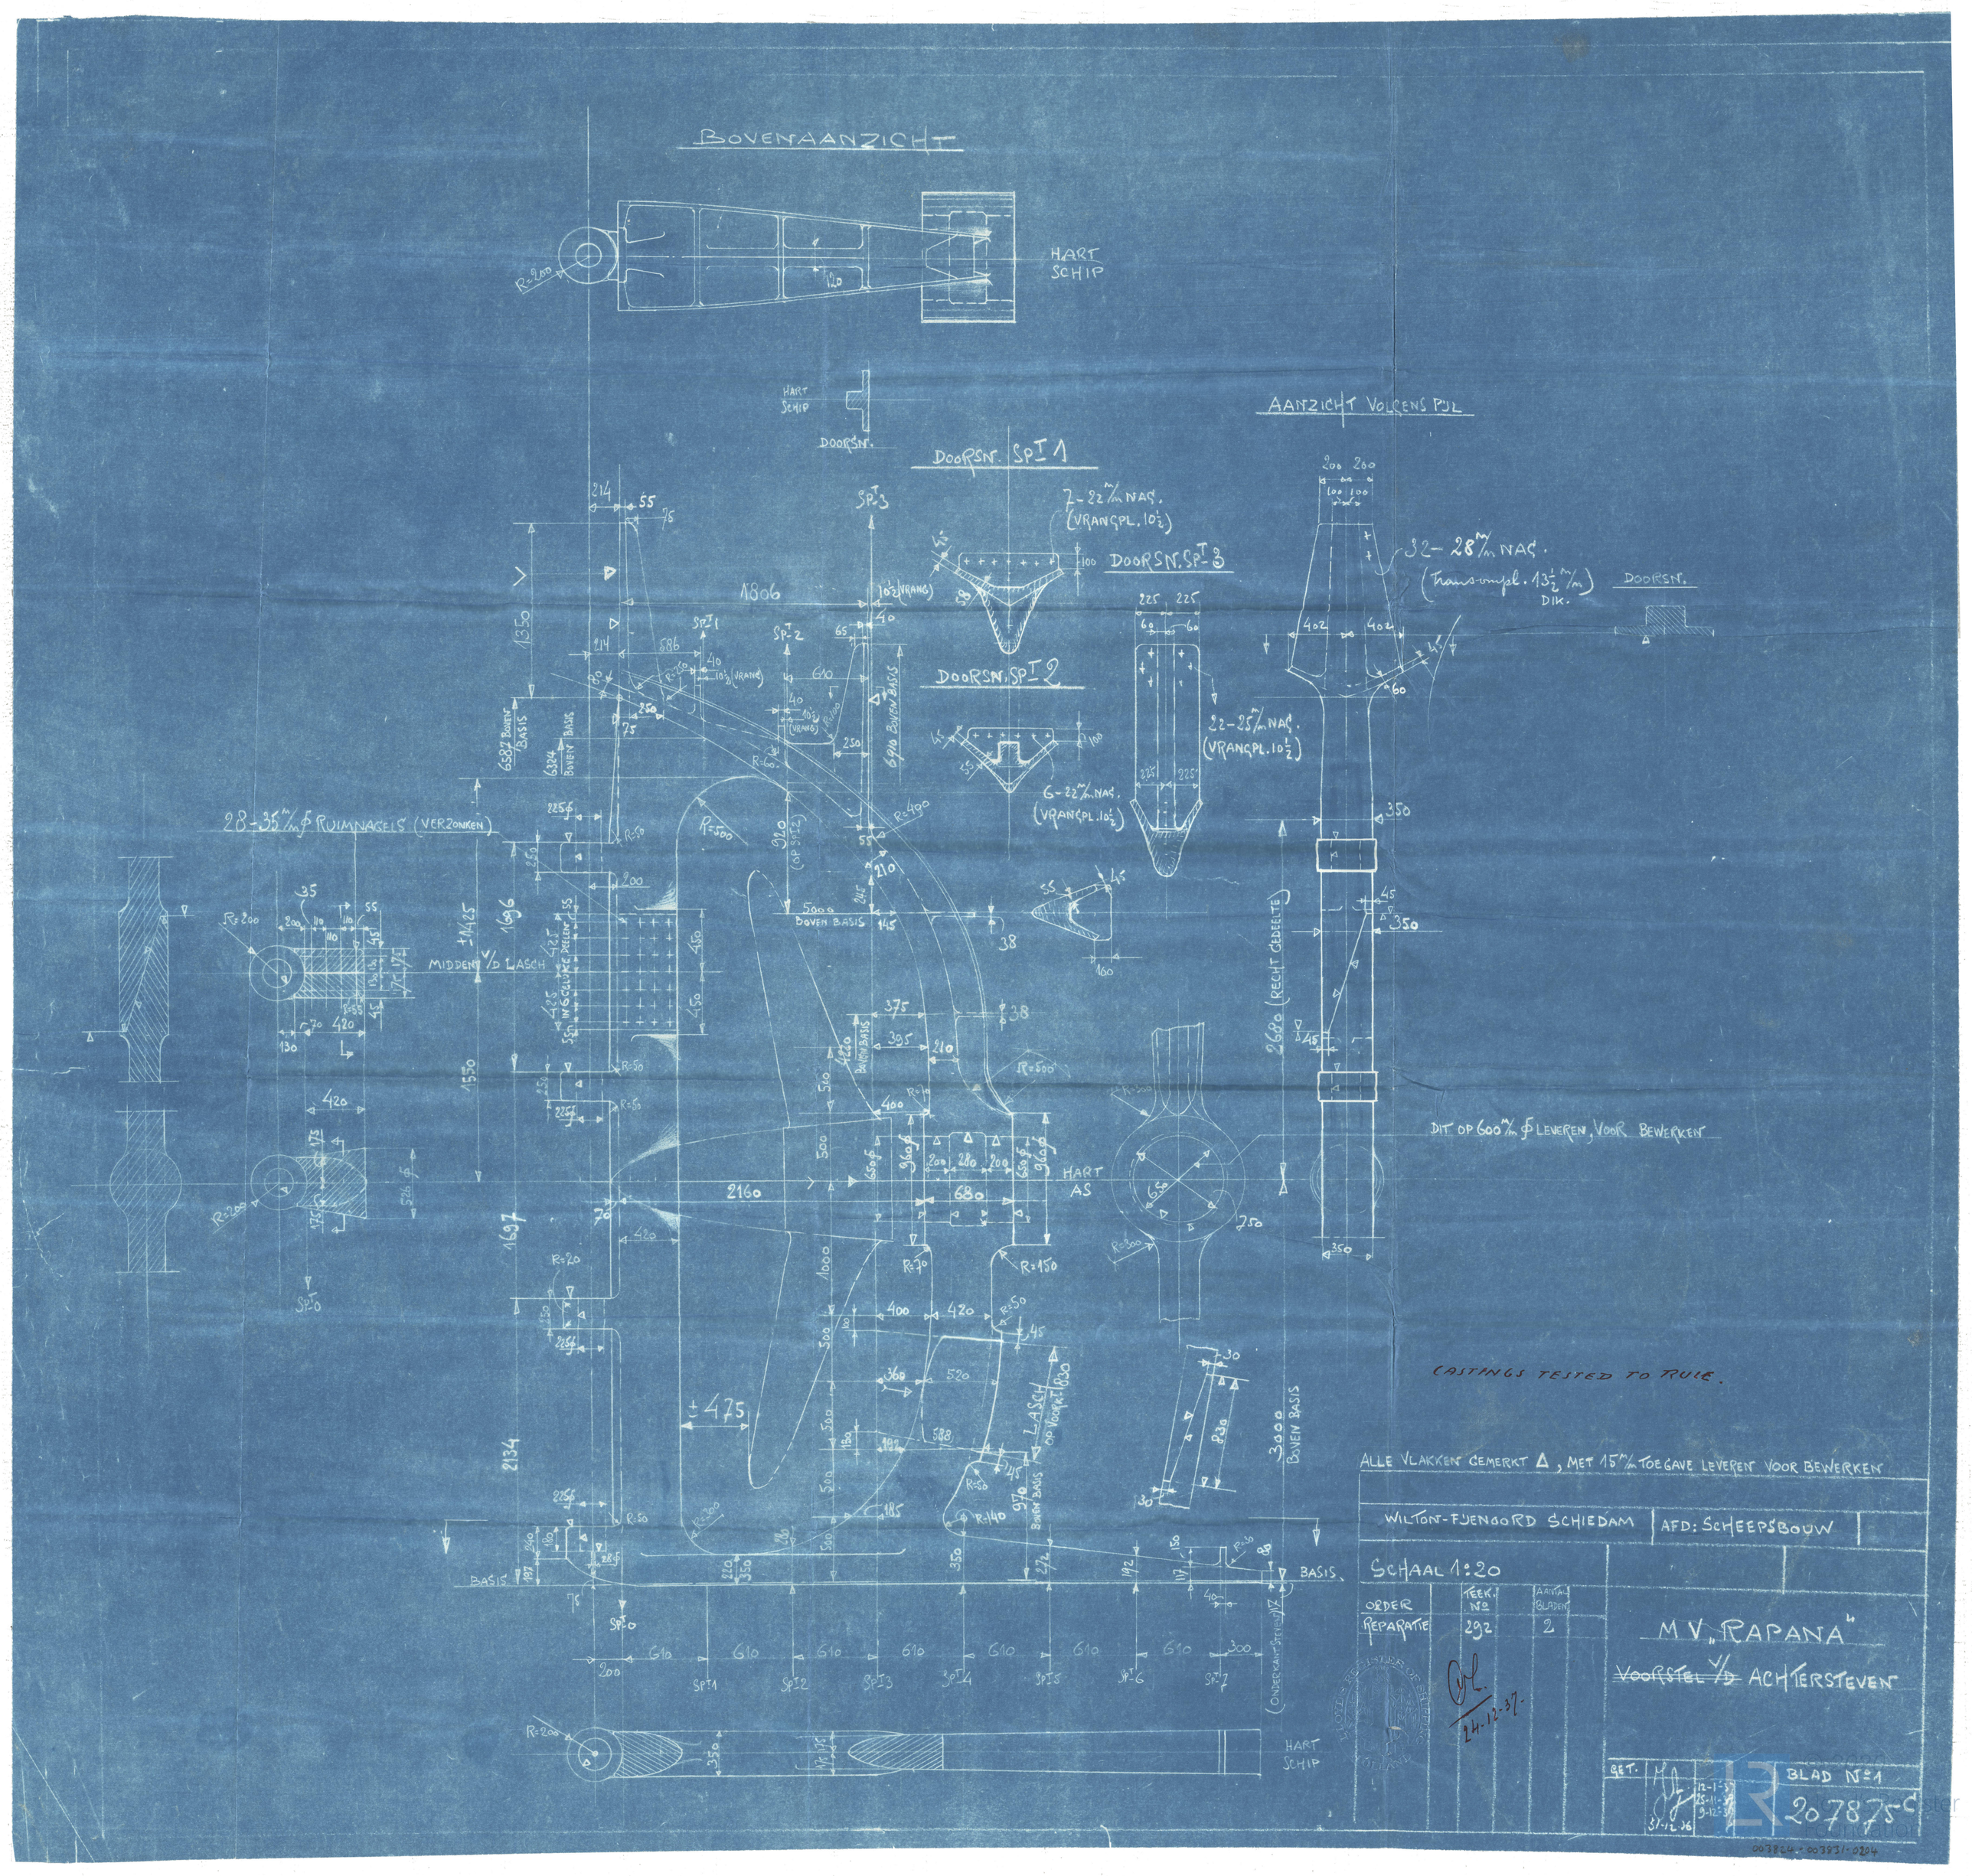
BOVENAANZICHT
HART SCHIP
DOORSN.
DOORSN. SPT 1
DOORSN. SPT 2
DOORSN. SPT 3
AANZICHT VOLGENS PIJL
7-22 m/m NAG. (VRANGPL. 10½)
6-22 m/m NAG. (VRANGPL. 10½)
22-25 m/m NAG. (VRANGPL. 10½)
32-28 m/m NAG. (Transomplt. 13½ m/m DIK.)
28-35 m/m ϕ RUIMNAGELS (VERZONKEN)
MIDDEN V/D LASCH
BOVEN BASIS
BOVEN BASIS
BOVEN BASIS
BOVEN BASIS
BOVEN BASIS
BOVEN BASIS
BASIS
BASIS
HART AS
HART SCHIP
LASCH OP VOORKANT
(ONDERKANT STEVEN)
(RECHT GEDEELTE)
DIT OP 600 m/m ϕ LEVEREN, VOOR BEWERKEN
CASTINGS TESTED TO RULE.
ALLE VLAKKEN GEMERKT Δ, MET 15 m/m TOEGAVE LEVEREN VOOR BEWERKEN
WILTON-FYENOORD SCHIEDAM
AFD: SCHEEPSBOUW
SCHAAL 1:20
ORDER REPARATIE
TEEK. No 292
AANTAL BLADEN 2
24-12-37
M.V. „RAPANA"
~~VOORSTEL V/D~~ ACHTERSTEVEN
GET.
31-12-36
12-1-37
25-11-37
9-12-37
BLAD No 1
207875-C

Rapana

Reg. Bxy. 25403

11/45

© 2020
Lloyd's Register Foundation

003824-003831-0196

M/V "RAPANA"

FRACTURES IN STERN FRAME
SHOWN IN RED.
SCALE:- 1:20

26/10/45.

R.K.D.

STARBOARD SIDE

PORT SIDE

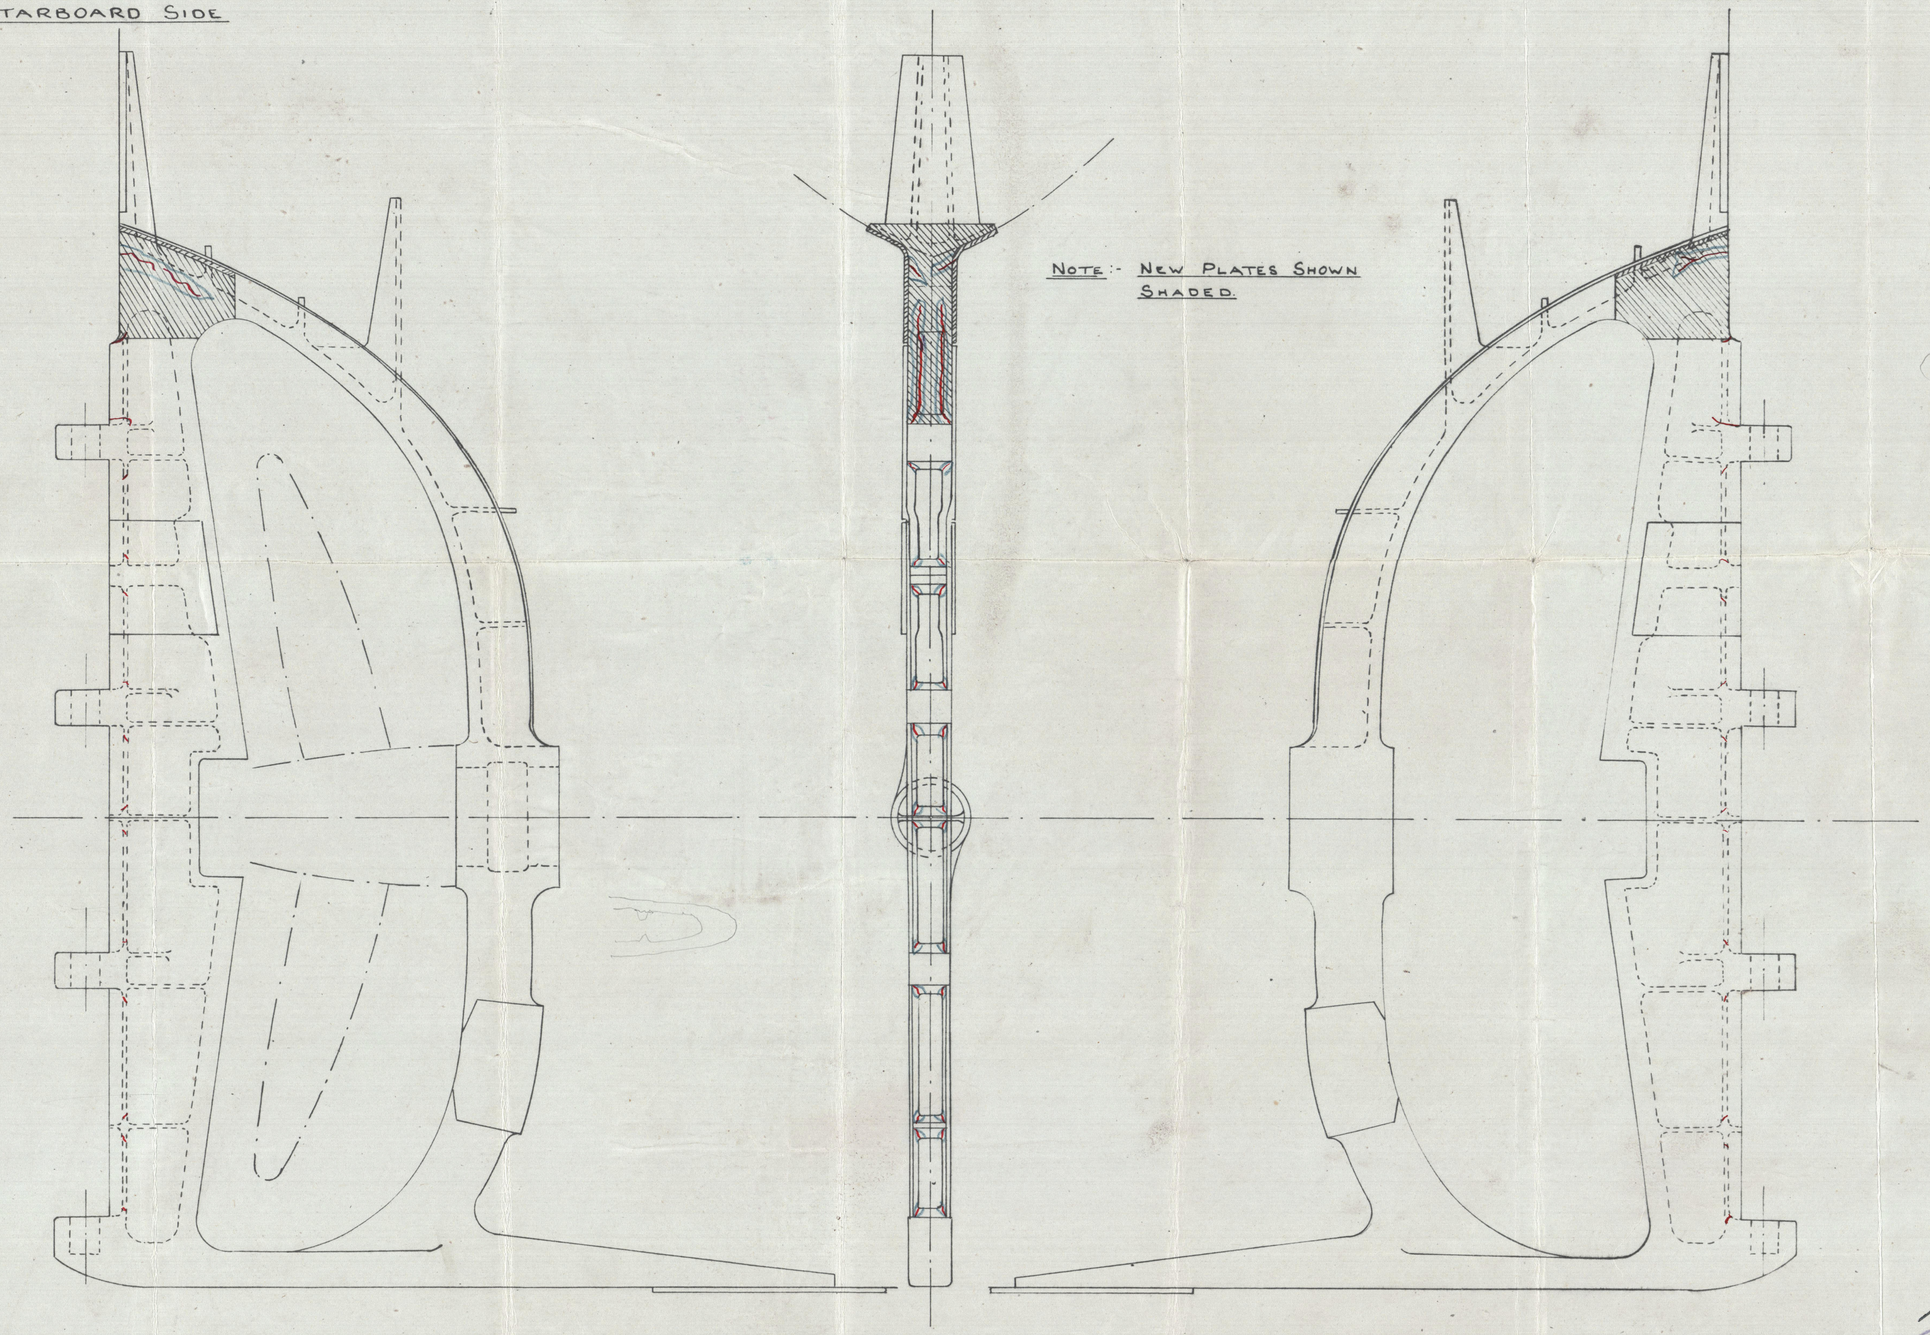

NOTE:- NEW PLATES SHOWN SHADED.

B.H. Sicks

LLOYD'S REGISTER OF SHIPPING BARRY
Guy. 11/45.

© 2020 Lloyd's Register Foundation

003824-003831-0196

"Rotula"

Rpt. No. Rot. 36580.

~~Rpt~~ Fractures on rudder post.

© 2020
Lloyd's Register Foundation
003824-003831-0191

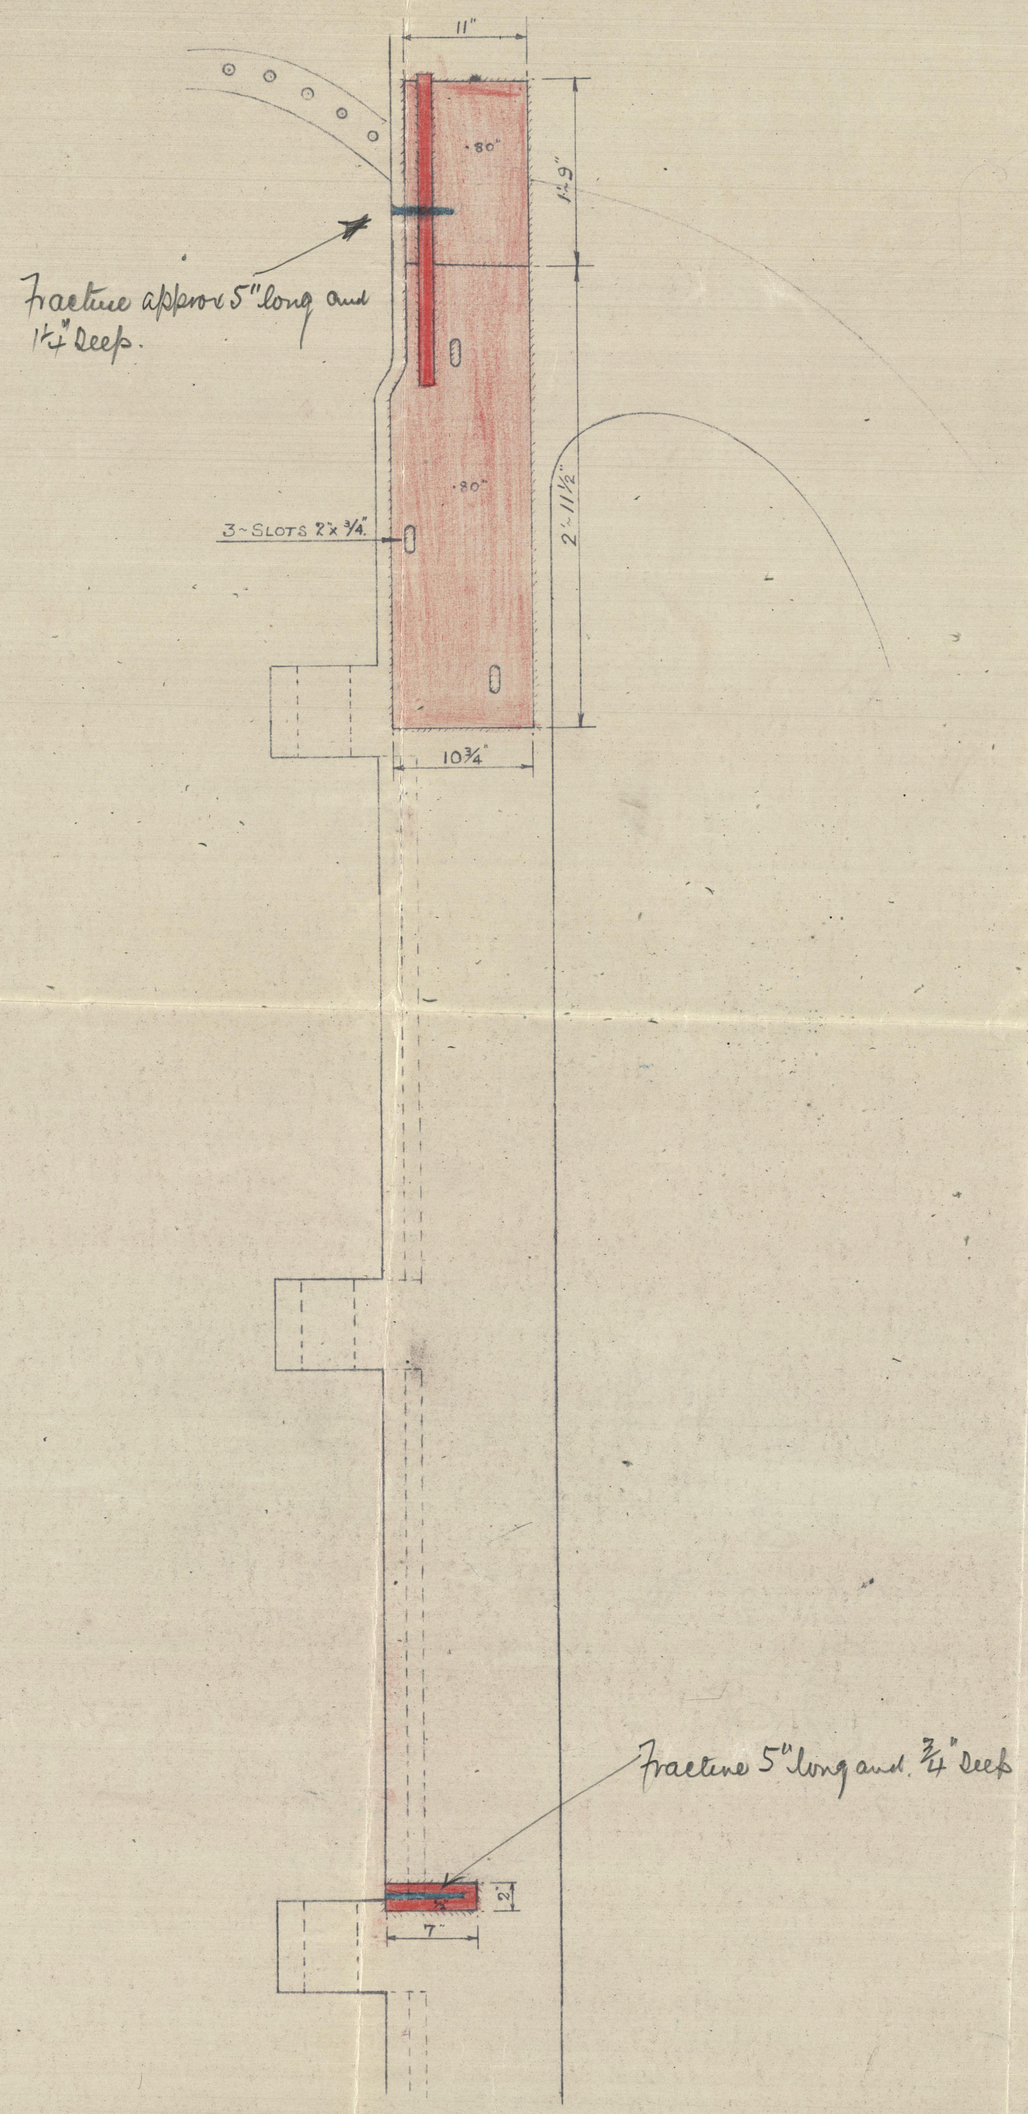

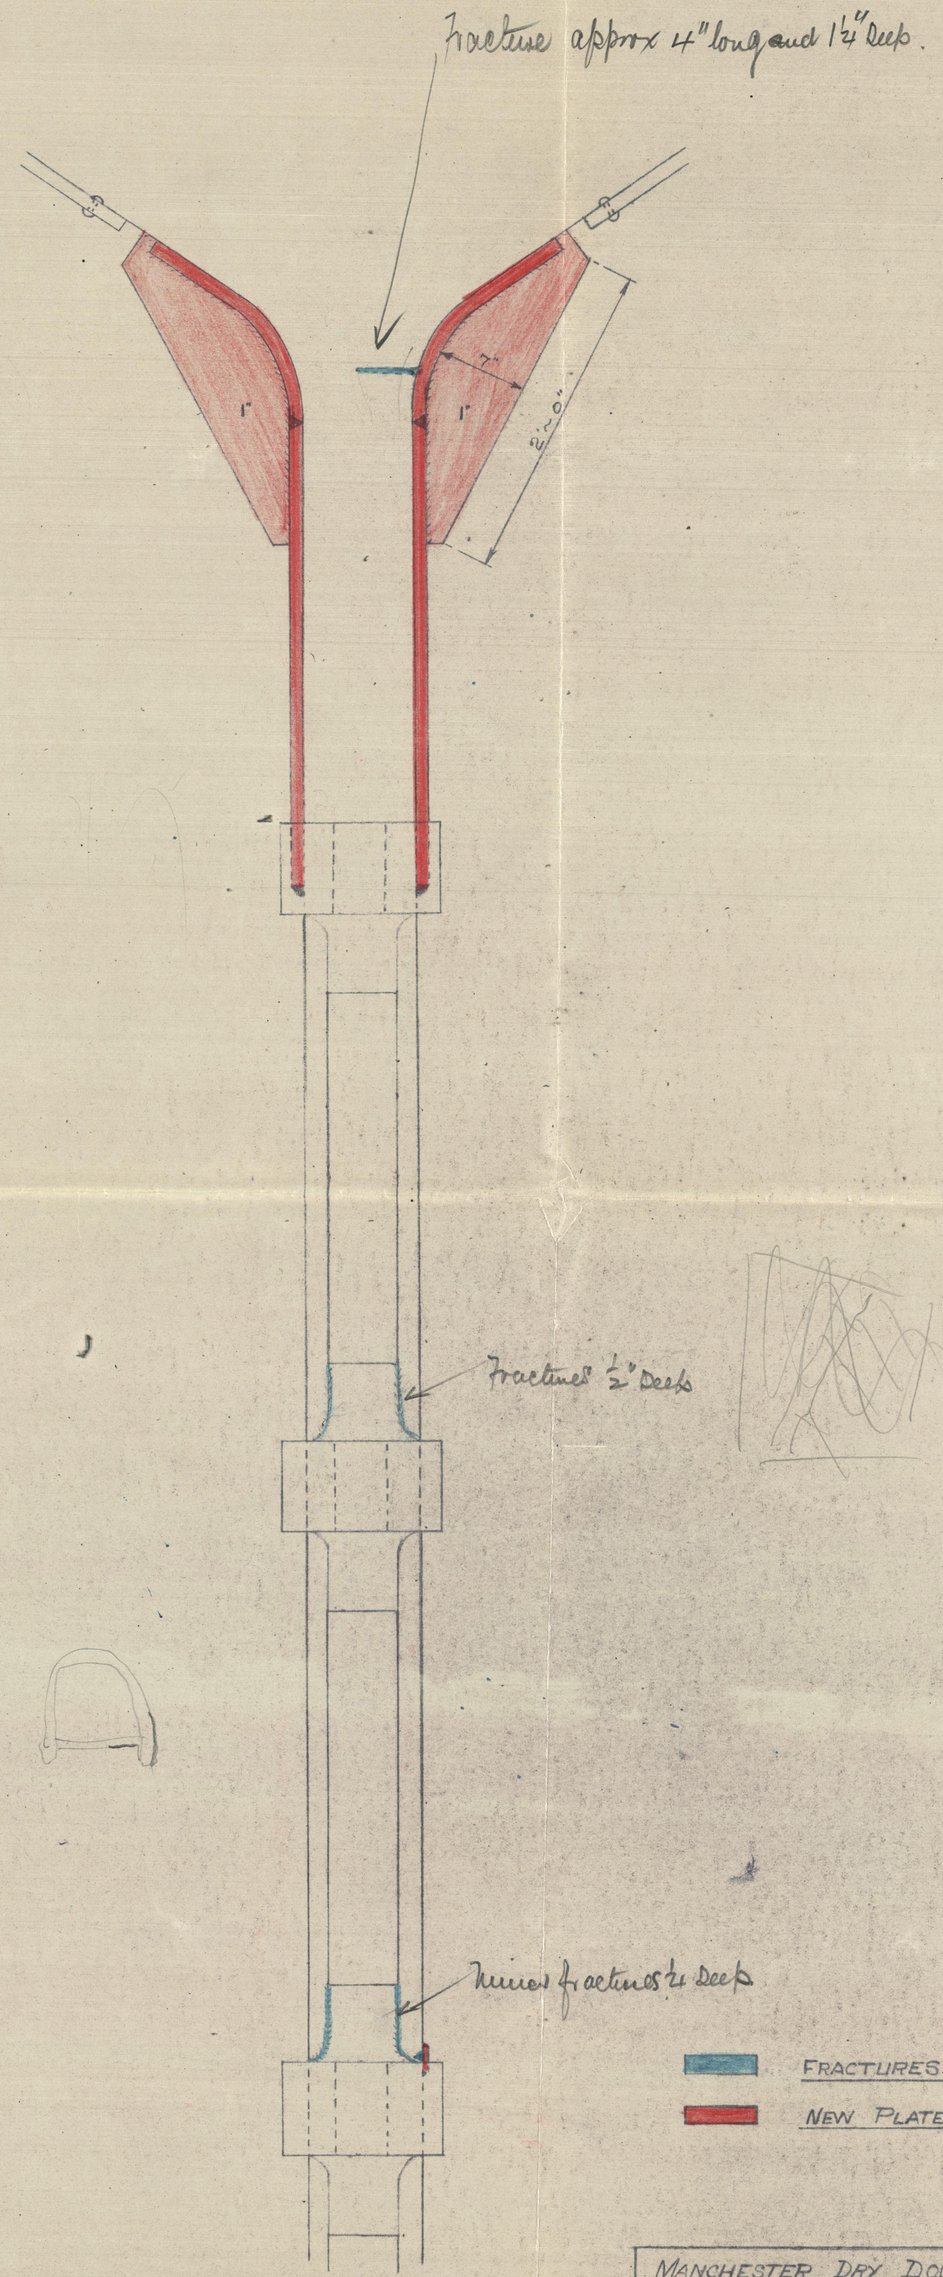

MANCHESTER DRY DOCKS Co LTD.		
M.V. "ROTULA."		
FRACTURES ON RUDDER POST.		
SCALE.	DATE.	DRG No.
—	DEC. 9. 52.	1455

© 2020 Lloyd's Register Foundation
003824-003831-0191